WIRING SCHEDULE						
WIRE No.	CONDUCTOR	COVERING TYPE	COVERING COLOUR	STOCK No.	FROM	TO
1	20 / 0.2		R	~~920202~~	BATT +	P1
2	20 / 0.2		BK	~~920202~~	BATT −	P2
3	16 / 0.2		R	~~930632~~	SW. / 2	P3
4	16 / 0.2		R	~~930632~~	SW. / 3	P4
5	16 / 0.2		R	~~930632~~	RES / 1	P5
6	16 / 0.2		R	~~930632~~	RES / 2	P6

FIT SLEEVE ~~930204~~ — 889 044

FIT SLEEVE ~~930204~~

PCB ~~IL2930~~ 361 974

FIT SLEEVE ~~930202~~ 787 116 TO RES/1 AND /2 (2 POSITIONS)

880 322

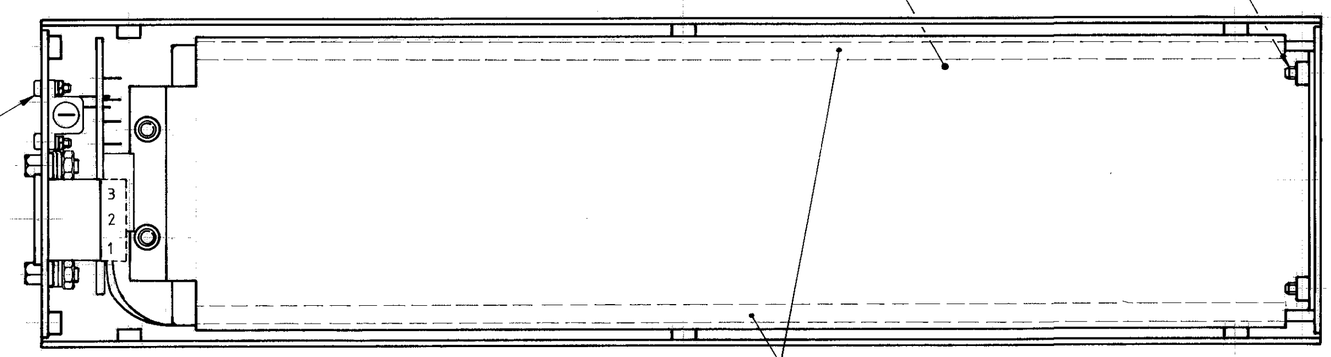

802 525 ~~130100~~
706 205 ~~820500~~ 2
704 106 ~~820600~~ 2
701 692 ~~820900~~ 2

501 621 ~~B3/2556~~

701 514 ~~830103~~ 4 POS'NS

761 055 ~~920110~~

FIT ALONG INSIDE EDGE OF BATTERY CLAMP ~~B3/2556~~. 501 621

501 622 ~~B2/2557~~

841 075 ~~710110~~

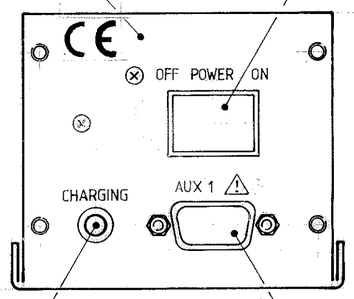

384 924 ~~IL2961~~

761 054 ~~920104~~

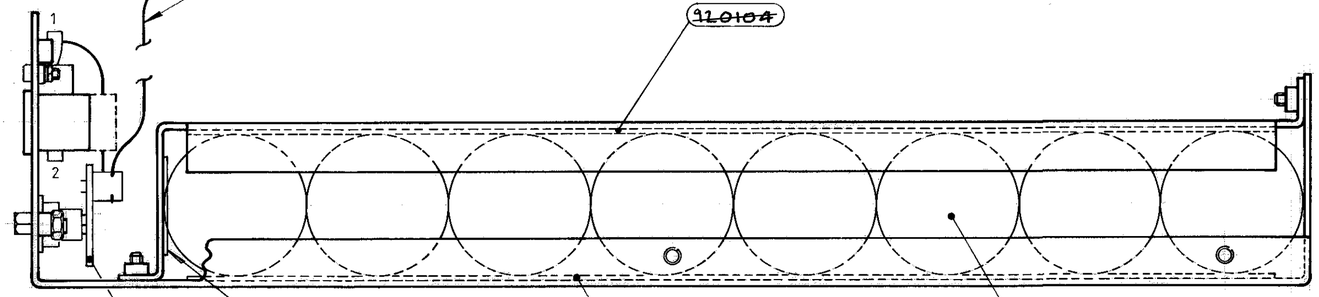

~~610000~~ 856 065
~~910500~~ 787 084

884 666 ~~590627~~
884 665 (2x) ~~880602~~ 2
761 056 ~~920023~~

~~IL2930~~ 361 974

761 053 ~~920107~~ FIT 2 STRIPS FULL WIDTH OF ~~B3/2556~~ 501 621

~~920105~~ 761 047

~~B2/3556~~ 205 009

DRG No.

MATERIAL	DIMENSIONS IN MILLIMETRES	TITLE
SEE ~~IL2606~~ 375 399 St	TOLERANCES UNLESS OTHERWISE STATED DIMS. TO 2 DEC. PLACES ± 0.1 DIMS. TO 1 DEC. PLACE ± 0.2 DIMS. WITHOUT DEC. PLACE ± 0.4 HOLE DIAMETER + 0.15 − 0 ANGULAR ± 0°30' SCREW THREADS B.A. TO B.S. 93 NORMAL UNIFIED TO B.S. 1580 ISO METRIC TO B.S. 3643 PT. 1,2 or 3 THIRD ANGLE PROJECTION	BATTERY BASE ASSEMBLY DRG.
FINISH		USED ON / QTY/UNIT

will'tek

DRAWN	TRACED	CHECKED	APPROVED	DATE	SCALE
P.H.		RB		13.12.89	1:1

DRAWING No. ~~A2/2606~~ 375 399

No.	DESCRIPTION	CHK'D	APP'D	DATE
4	SEE C/N No. 92047			
3	SEE C/N No. 91043			3/5/01
2	SEE C/N No. 90030	RB		14/02/90
1	REDRAWN SEE C/N 89099	RB		19/12/89

REVISIONS

N°	DESCRIPTION	CHK'D	APP'D	DATE
8	C/N 00019	KM		9/10/00
7	C/N 97049	BDE		07.05.97
6	C/N 96121	RB		12.2.97
5	C/N 96041	RB		18.4.96
	FACTORY ISSUE			15/02/93

No	DESCRIPTION	CHK'D	APP'D	DATE
11	0206.14	Schn.	Roas	15.07.02
10	0106.02	BDE	BS	19.11.01
9	C/N 01013	KM		23/2/1

A PRODUCT OF THE UNO RANGE-ENGINEERS CAT. No. 7302

This drawing is property of Willtek Communications GmbH. Reproduction, unauthorized use, communication to a third party is liable to prosecution and liable for damages.